


AS-BUILT UNIT PLAN

UNIT	AS OF	VERSION
1000	10/1/21	UP - 1

TENANT SUMMARY	
OFFICE AREA	7,441 SF
TOTAL	7,441 SF

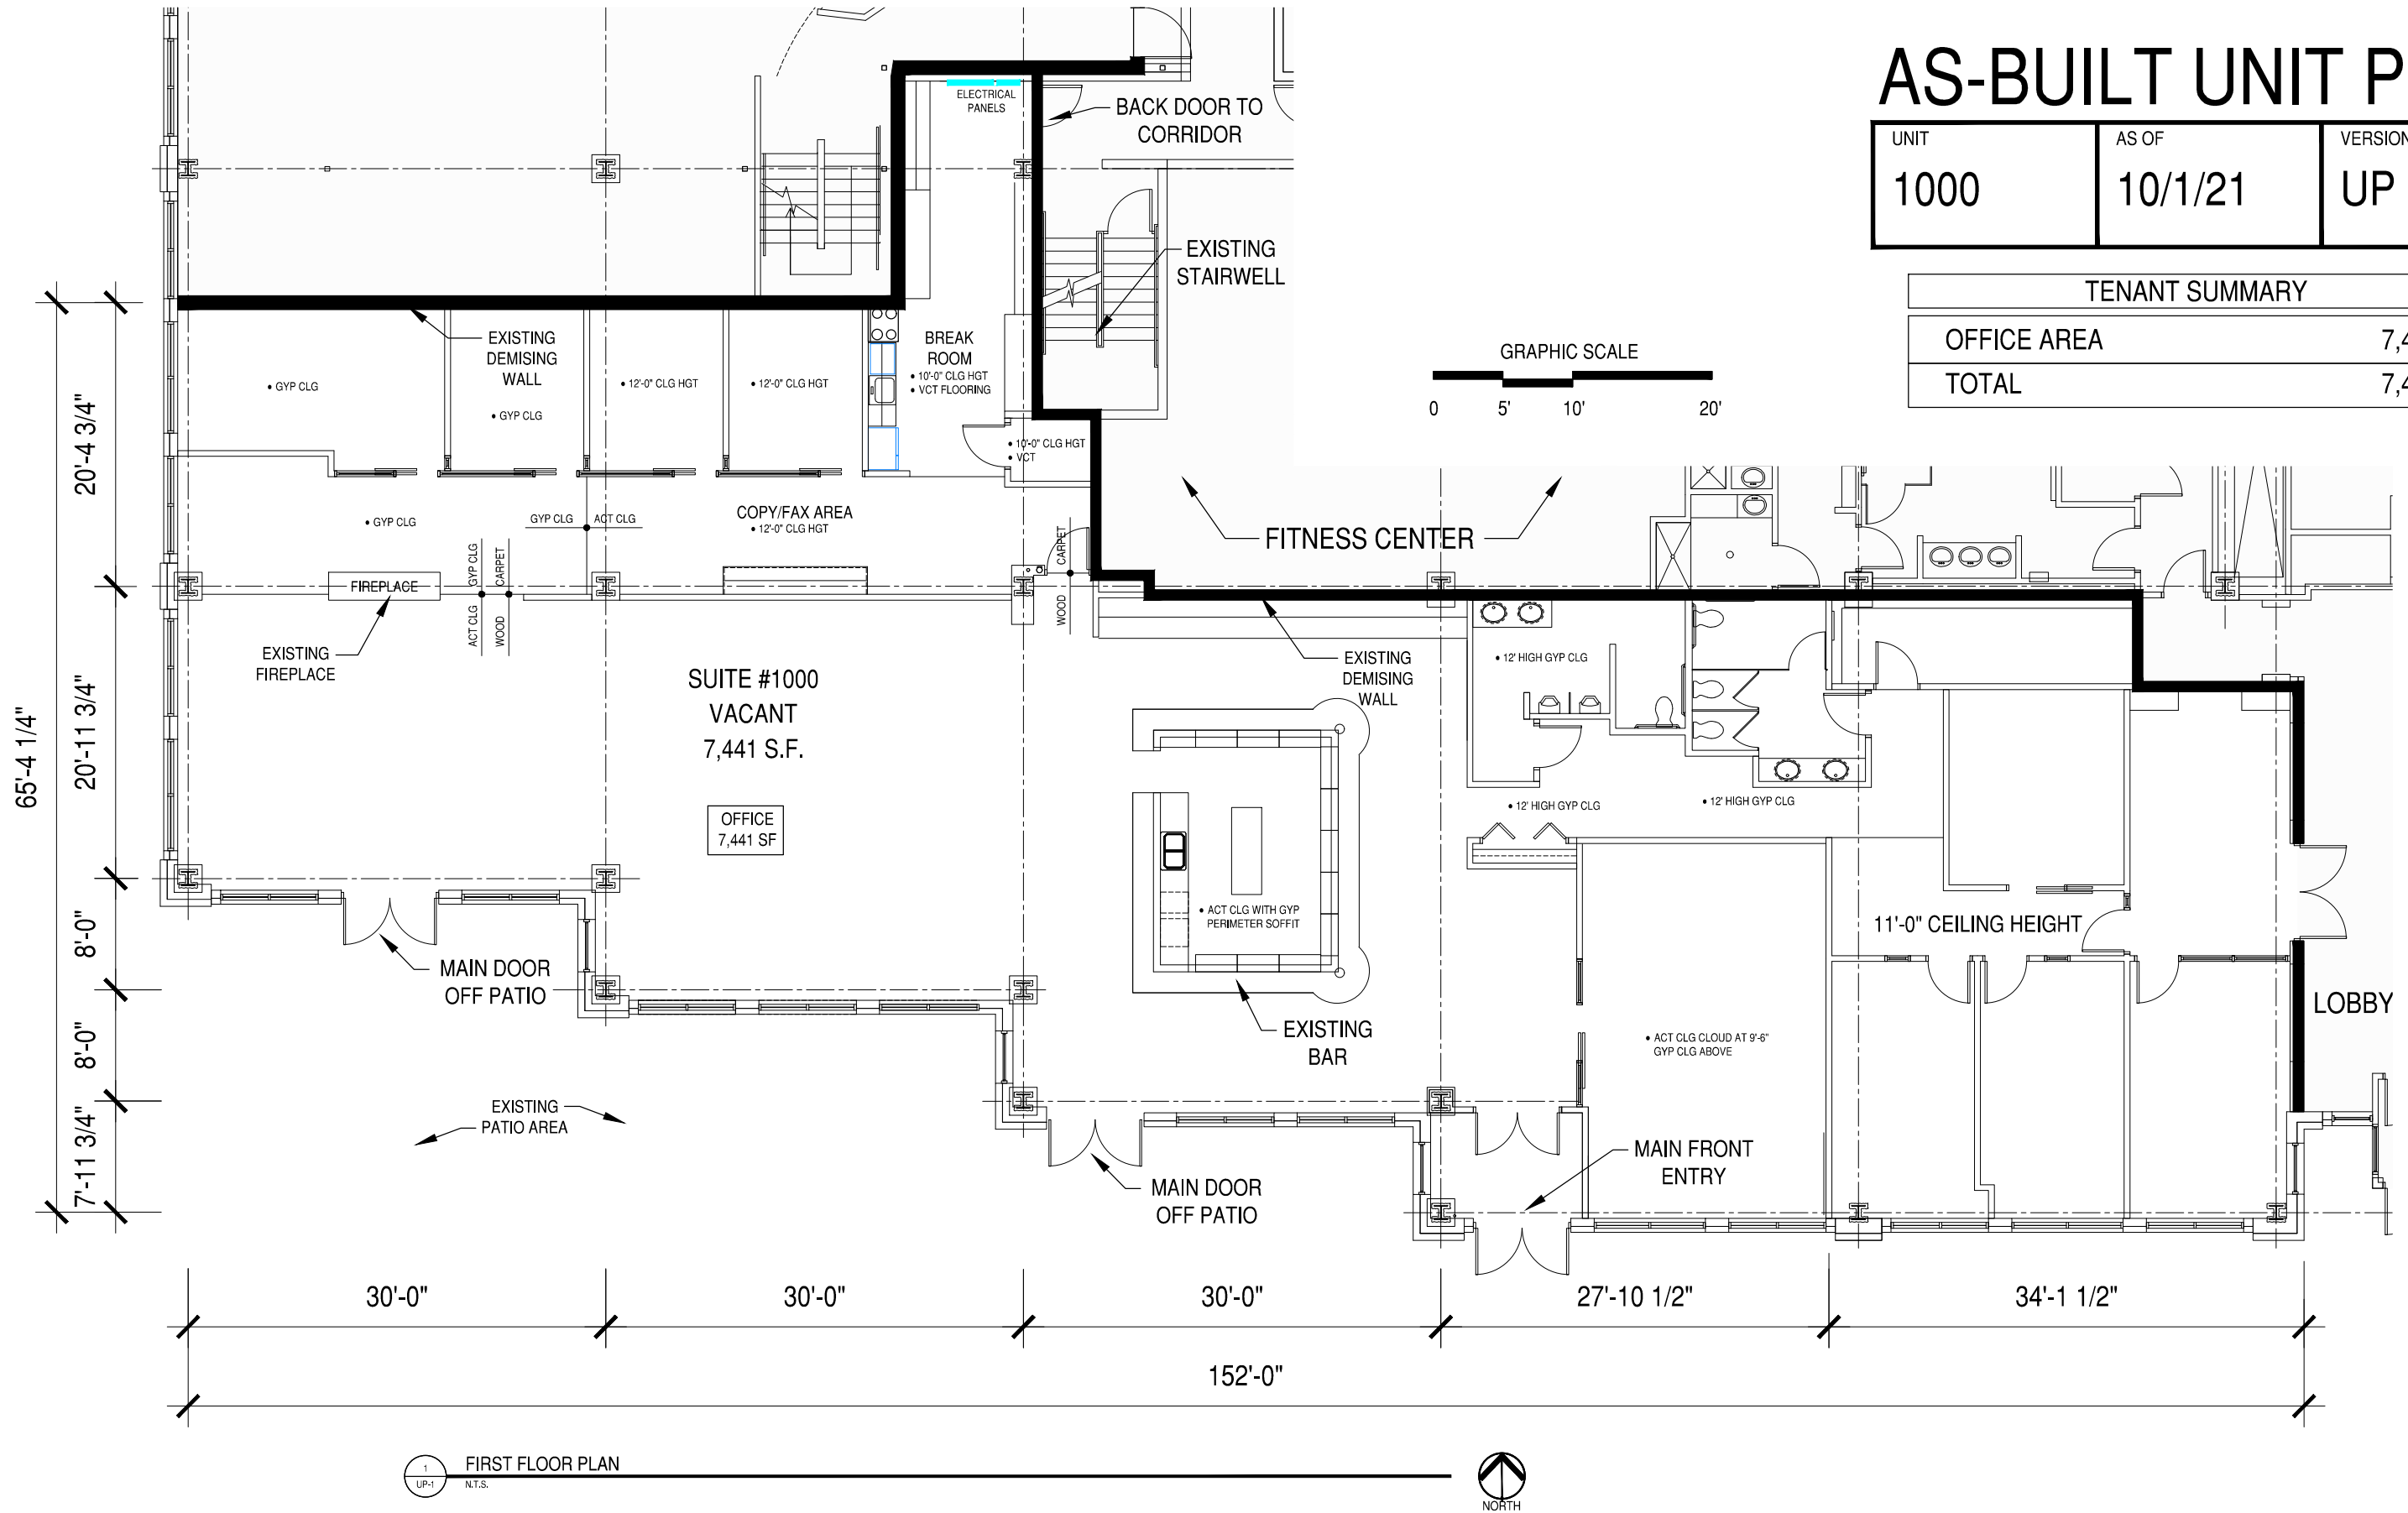

G:\Arch 2000\Projects\Active\Depot Office Center\Tenant\As-Built\Unit 1000\Unit 1000.dwg