


AS-BUILT UNIT PLAN

UNIT	AS OF	VERSION
2710	3/29/23	UP - 1

TENANT SUMMARY	
RETAIL	1,397 SF
STOCK	932 SF
TOTAL	2,329 SF

----- DASHED LINE INDICATES RETAIL / STOCK SEPARATION

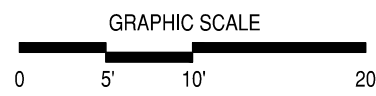

1 FLOOR PLAN
UP-1
SEE GRAPHIC SCALE



G:\Arch 2000\Projects-Active\CSM Retail\Century Hills Shopping Center\Tenant As-Built\Unit 2710\Unit 2710.dwg

