


1 FLOOR PLAN
UP-1
SEE GRAPHIC SCALE

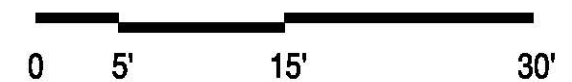

GRAPHIC SCALE



AS-BUILT UNIT PLAN

| UNIT | AS OF | VERSION |
|------|---------|---------|
| 4214 | 5/28/20 | UP - 1 |

TENANT SUMMARY - AVAILABLE

| | |
|-------------|----------|
| RETAIL AREA | 4,927 SF |
| TOTAL | 4,927 SF |