


G:\Arch\2000\Projects-Active\CSM Retail\Rochester Shopping Center\Tenants-As-Built\Unit\_4208\Unit\_4208.dwg

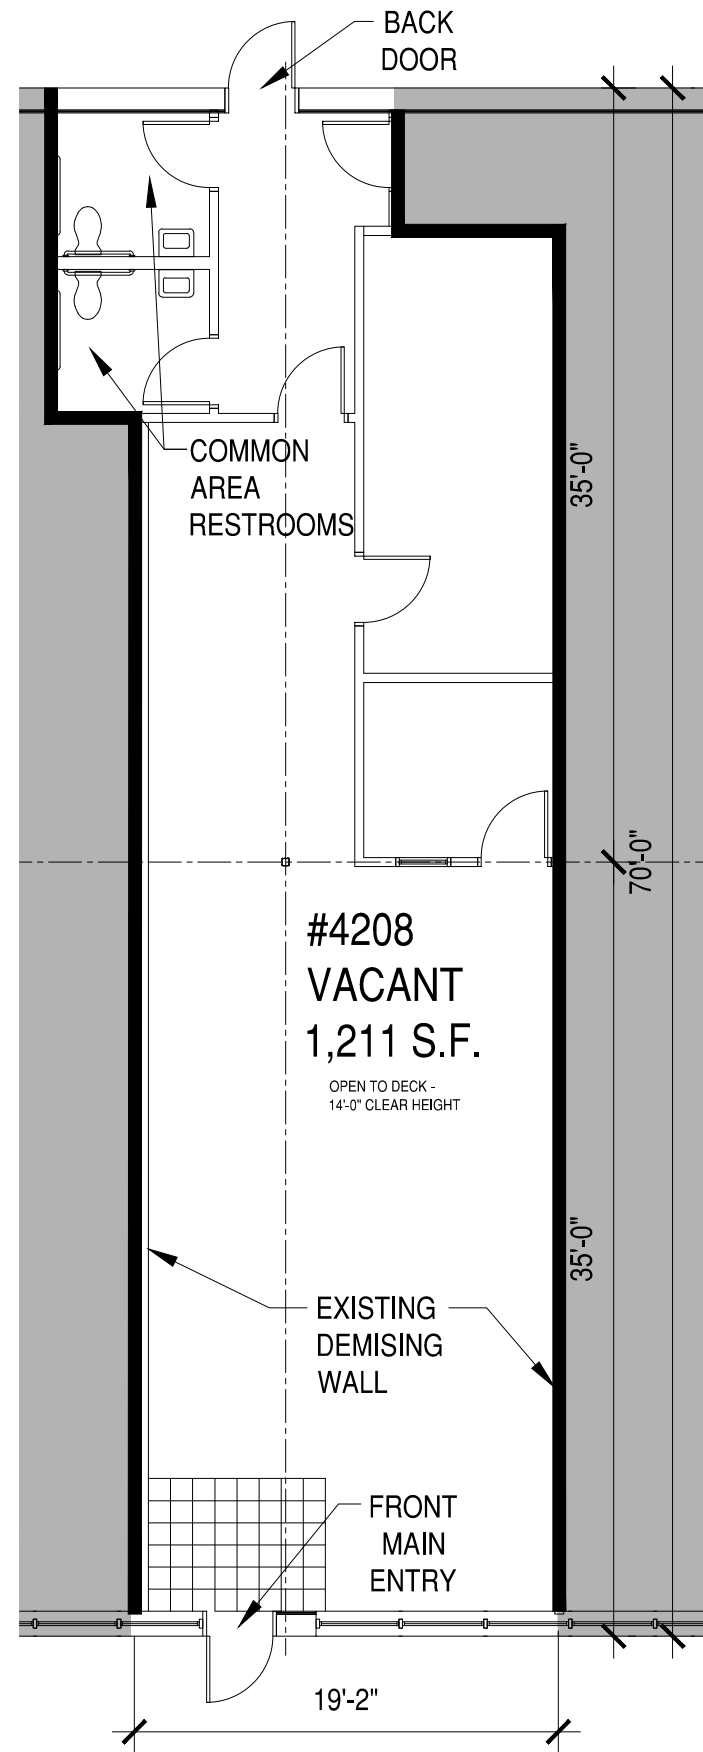

1 FLOOR PLAN  
UP-1 SEE GRAPHIC SCALE



## AS-BUILT UNIT PLAN

UNIT	AS OF	VERSION
4208	8/11/23	UP - 1

TENANT SUMMARY - AVAILABLE	
RETAIL AREA	1,211 SF
TOTAL	1,211 SF

### GRAPHIC SCALE

